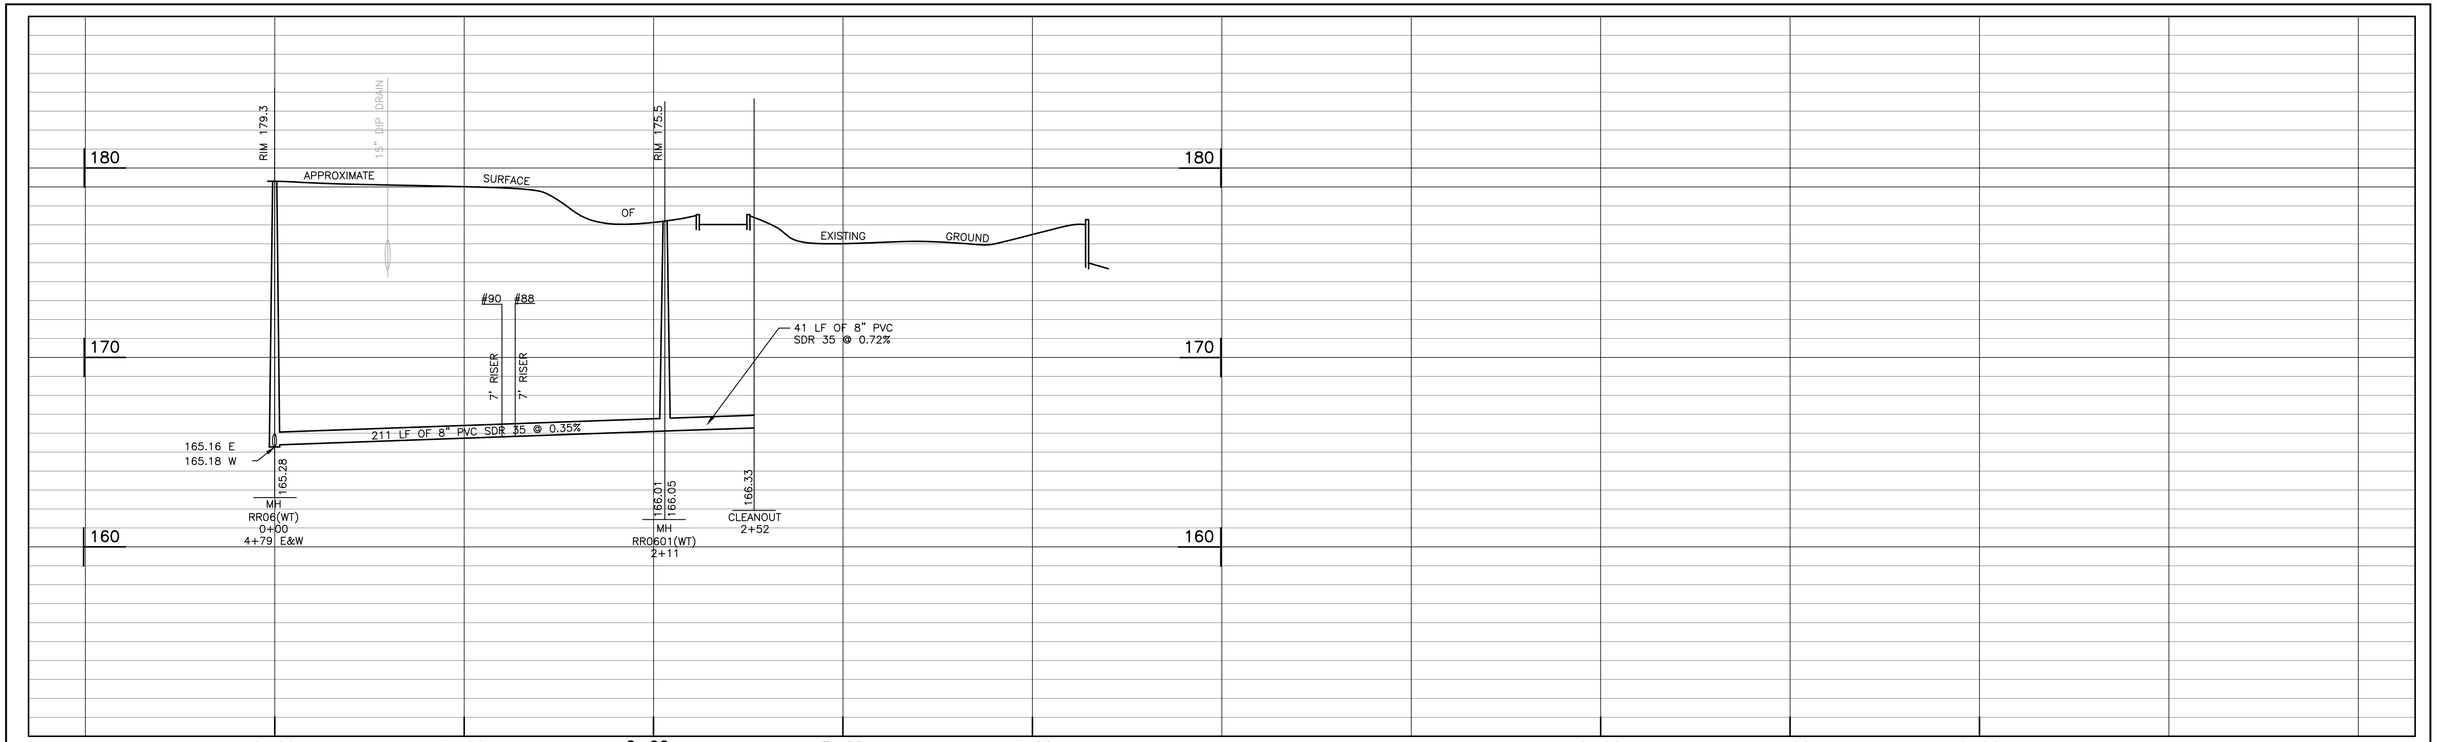

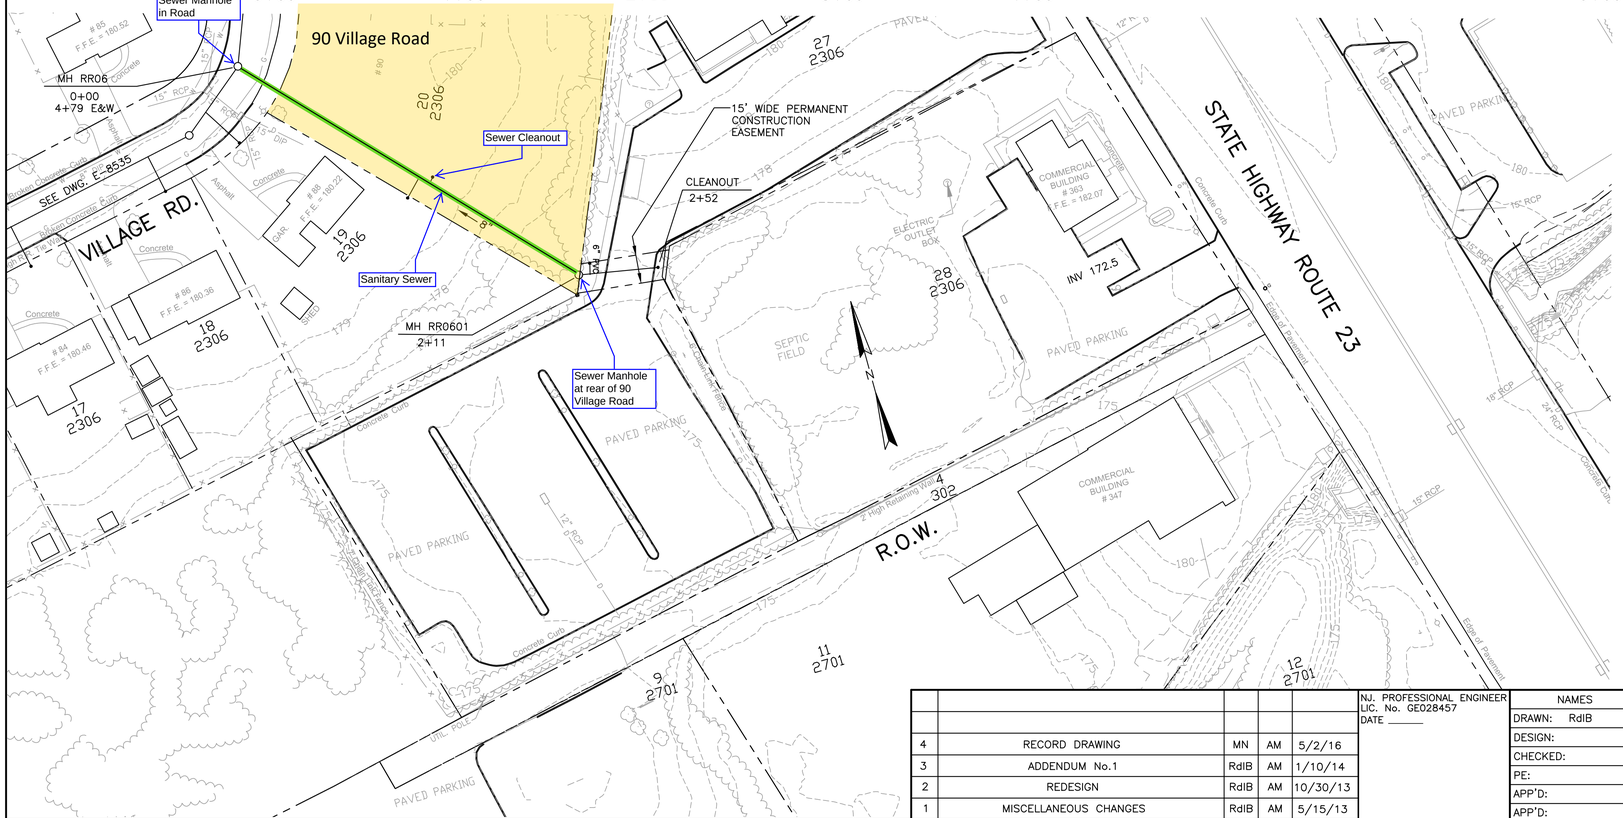

NOTES:

1. WHERE SHOWN, RIGHT-OF-WAY LINES AND EASEMENT LINES ARE FOR ILLUSTRATIVE PURPOSE ONLY. THESE PLANS SHOULD NOT BE USED FOR SCALING OF DIMENSIONS, OR FOR DETERMINING RIGHT-OF-WAY AND PROPERTY LIMITS.

2. ORIGINAL SURVEY AND TOPOGRAPHIC BASE MAPPING WAS PREPARED BY GEOD CORPORATION, NEWFOUNDLAND, NJ DATED 2008.

3. ELEVATIONS ARE BASED ON A DATUM THAT IS APPROXIMATELY 0.24 FT ABOVE USGS, NGVD 1929 DATUM, US SURVEY FEET.

4. HORIZONTAL CONTROL IS BASED ON N.J.S.P.C.S. (NAD83).

5. THE PLANS SHOW THE EXISTING CONDITIONS WHICH WERE LIKELY TO AFFECT THE PROSECUTION OF THE SANITARY SEWER CONSTRUCTION WORK. THE CONTRACT DOCUMENTS WERE PREPARED BASED ON FIELD INSPECTIONS, SURVEYS, AND CONDITIONS EXISTING AT THE TIME OF PREPARATION AND OTHER AVAILABLE RECORD INFORMATION. LOCATIONS OF EXISTING UTILITIES SHOWN ON THE PLANS WERE DETERMINED BY STANDARD SURVEYING METHODS, AVAILABLE RECORDS, AND THROUGH SOLICITATIONS OF THE RESPECTIVE UTILITY OWNERS. LOCATIONS OF THE EXISTING UTILITIES SHOWN ARE APPROXIMATE AND NEITHER THE INFORMATION NOR THE EXACT LOCATION OF THESE UTILITIES AS SHOWN IS GUARANTEED TO BE COMPLETE OR CORRECT. THERE MAY BE UNDERGROUND UTILITIES OTHER THAN THOSE SHOWN ON THE PLANS. NOT ALL WATER, GAS, SEWER, ELECTRIC, AND TELEPHONE SERVICES ARE SHOWN ON THE PLANS.

40 0 40 80 FT.
SCALE: 1" = 40' HOR.
1" = 4' VERT.

The drawings, specifications and other documents prepared by the Engineer for this project are instruments of the Engineer's service for use solely with respect to this project and, unless otherwise provided, the Engineer shall be deemed the author of these documents and shall retain all common law, statutory and other reserved rights, including the copyright.

NO.	REVISIONS	MADE	CHK	DATE
4	RECORD DRAWING	MN	AM	5/2/16
3	ADDENDUM No.1	RdlB	AM	1/10/14
2	REDESIGN	RdlB	AM	10/30/13
1	MISCELLANEOUS CHANGES	RdlB	AM	5/15/13

NJ. PROFESSIONAL ENGINEER
LIC. No. GE028457
DATE _____
MICHAEL SIMONE JR.

NAMES	DATE
DRAWN: RdlB	6/9/09
DESIGN:	9/17/09
CHECKED:	9/17/09
PE:	
APP'D:	
APP'D:	
APP'D:	

TOWNSHIP OF PEQUANNOCK
MORRIS COUNTY, NEW JERSEY

SPA AREA
STA. 0+00 TO STA. 2+52

VILLAGE AREA SEWERS-CONTRACT 14-3

PEQUANNOCK NEW JERSEY

CREW | Water Wastewater Environmental Civil Engineering
Crew Engineers, Inc. Butler, New Jersey

PROJECT NUMBER: PEQ032.000

DWG. NO.: E-8537 | SCALE: AS SHOWN

NJ Certificate of Authorization 24GA27920500 | SHEET NUMBER 29 OF 69